


- Key**
- ▭ Rampion Lease Boundary
 - ▲ Meteorological Mast
 - Offshore Substation (Legs Installed)
 - ⋈ Installed Turbines
 - Buried Cables

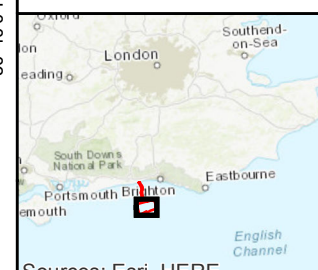

Sources: Esri, HERE, DeLorme, Intermap, increment P Corp., GEBCO,

© OceanWise Limited, 2015.
 © British Crown Copyright, 2015.
 All rights reserved.

Development:
 Rampion Offshore Wind Farm

Plan Title: Rampion Offshore Wind Farm Installation Update 21/09/2017

Doc ref: ROWAsBITSC79

Date: 21/09/2017

0 250 500
Metres

N

Coordinate System: WGS 1984 UTM Zone 30N
 Datum: WGS 1984

Dwg Ref: RAMPIONROW_TCE_Lease_AsBuilt_170921ag

1:37,000 Paper Size: A3 Date: 21/09/2017

Author:	Rampion Offshore Wind Limited		
Rev:	By:	Amendments:	Date:
20	AG	20th Issue	18/07/2017
21	AG	21st Issue	31/07/2017
22	AG	22nd Issue	07/08/2017
23	AG	23rd Issue	16/08/2017
24	AG	24th Issue	22/08/2017
25	AG	25th Issue	05/09/2017
26	AG	26th Issue	21/09/2017

NOTE:
 All construction vessels will have a 500m radius safety zone, from time to time this zone will go beyond the TCE Lease boundary